ROUTE NO.	SECTION	COUNTY	TOTAL SHEETS	SHEET NO.
FAI.80	50-5	LA SALLE	229	14
STA. 715+00		TO STA. 745+00		
FED. ROAD DIST. NO. 7	ILLINOIS	PROJECT		

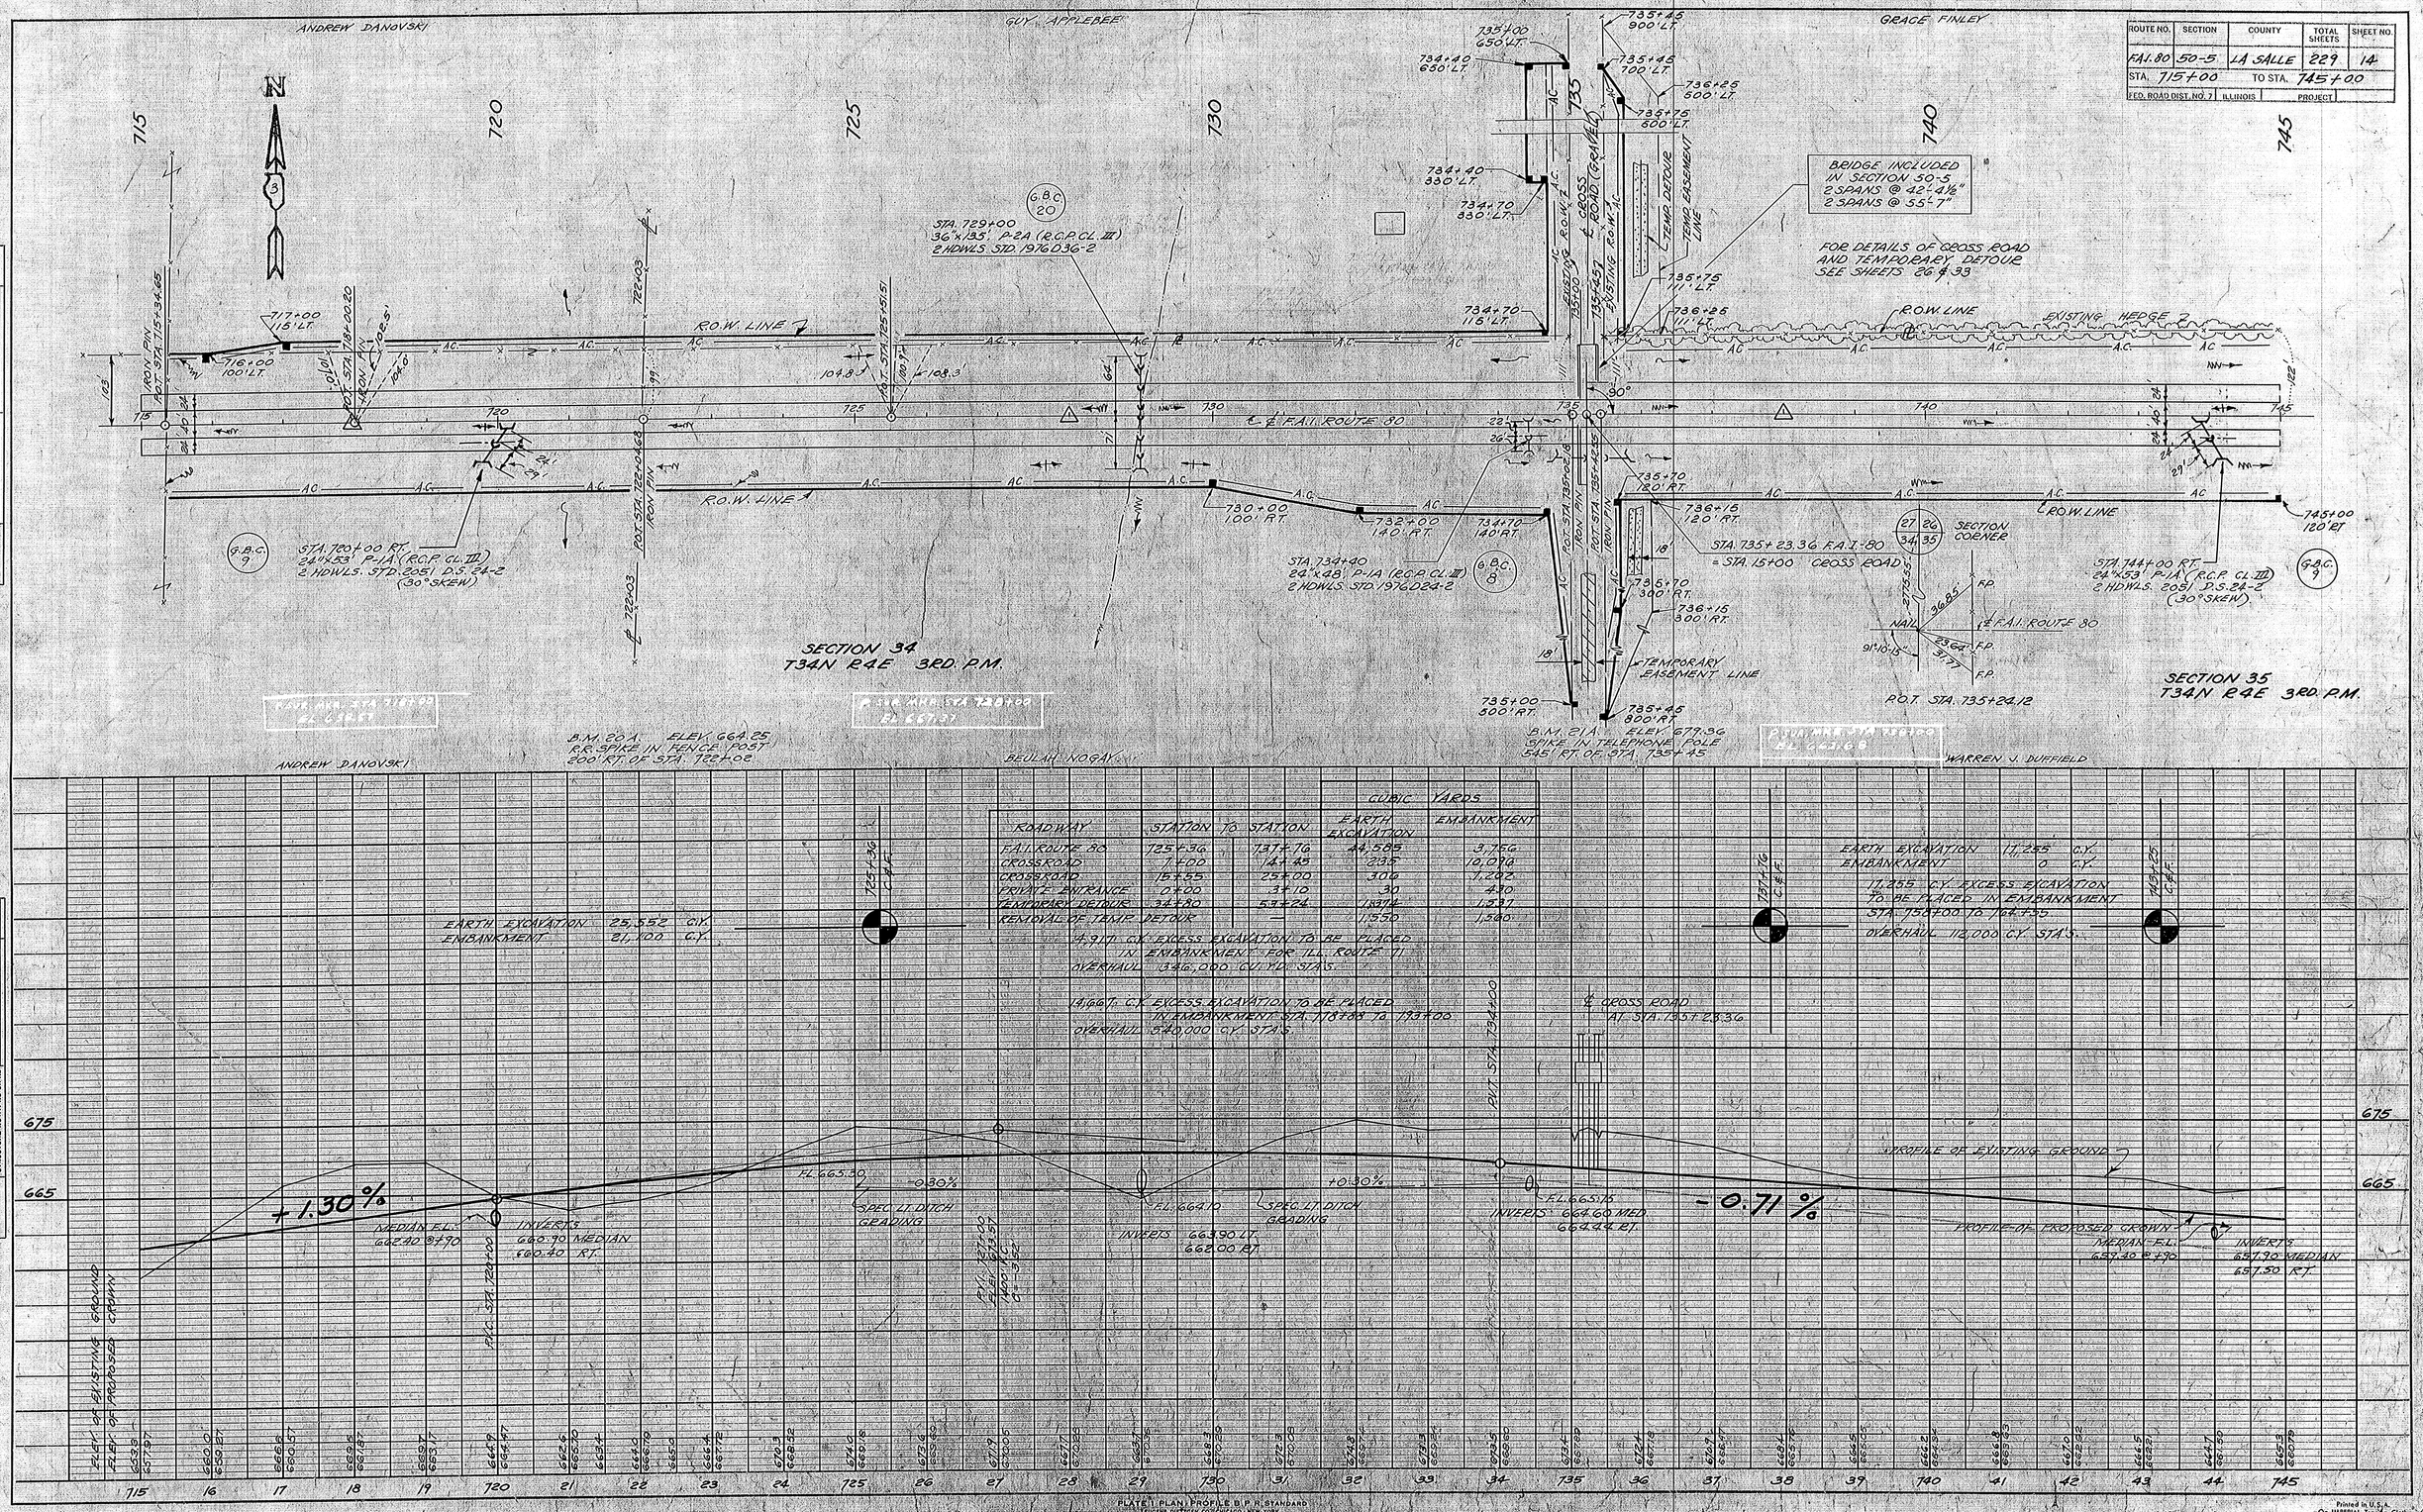

ROADWAY	STATION	TO STATION	CUBIC YARDS EARTH EXCAVATION	CUBIC YARDS EMBANKMENT
F.A.I. ROUTE 80	725+36	737+76	44,585	3,756
CROSSROAD	7+00	14+45	235	10,096
CROSSROAD	15+55	25+00	306	1,202
PRIVATE ENTRANCE	0+00	3+10	30	430
TEMPORARY DETOUR	34+80	53+24	1,374	1,537
REMOVAL OF TEMP. DETOUR	—		1,550	1,560

PLATE 1 PLAN PROFILE B.P.R. STANDARD