ROUTE NO.	SECTION	COUNTY	TOTAL SHEETS	SHEET NO.
F.A.I. 80	50-5	LA SALLE	229	16
STA. 775+00		TO STA. 805+00		
FED. ROAD DIST. NO. 7	ILLINOIS	PROJECT		

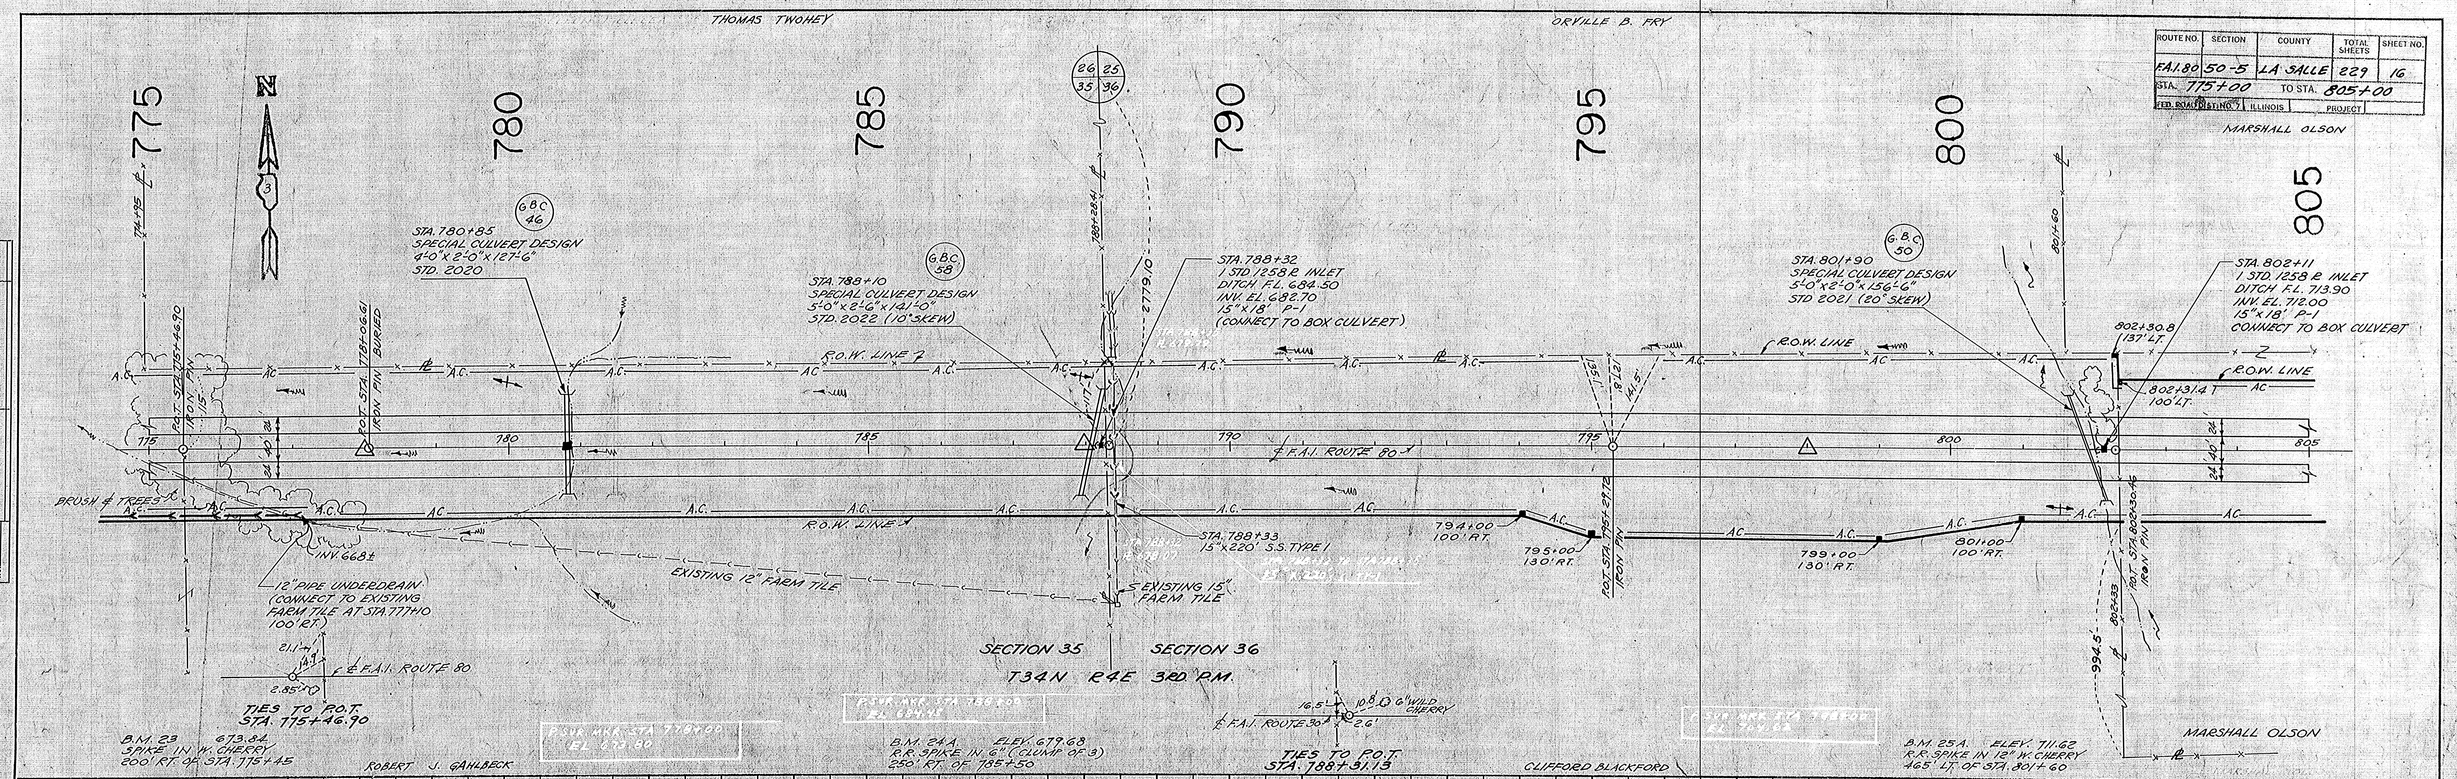

PLATE 1 PLAN - PROFILE B.P.R. STANDARD
EUGENE DIETZGEN CO. CHICAGO - NEW YORK

Printed in U.S.A. On IMPERIAL Tracing Cloth

Printed in U.S.A. On IMPERIAL Tracing Cloth