ROUTE NO.	SECTION	COUNTY	TOTAL SHEETS	SHEET NO.
F.A.I. 80	50-5	LA SALLE	229	17
STA. 805+00		TO STA. 835+00		
FED. ROAD DIST. NO. 7	ILLINOIS	PROJECT		

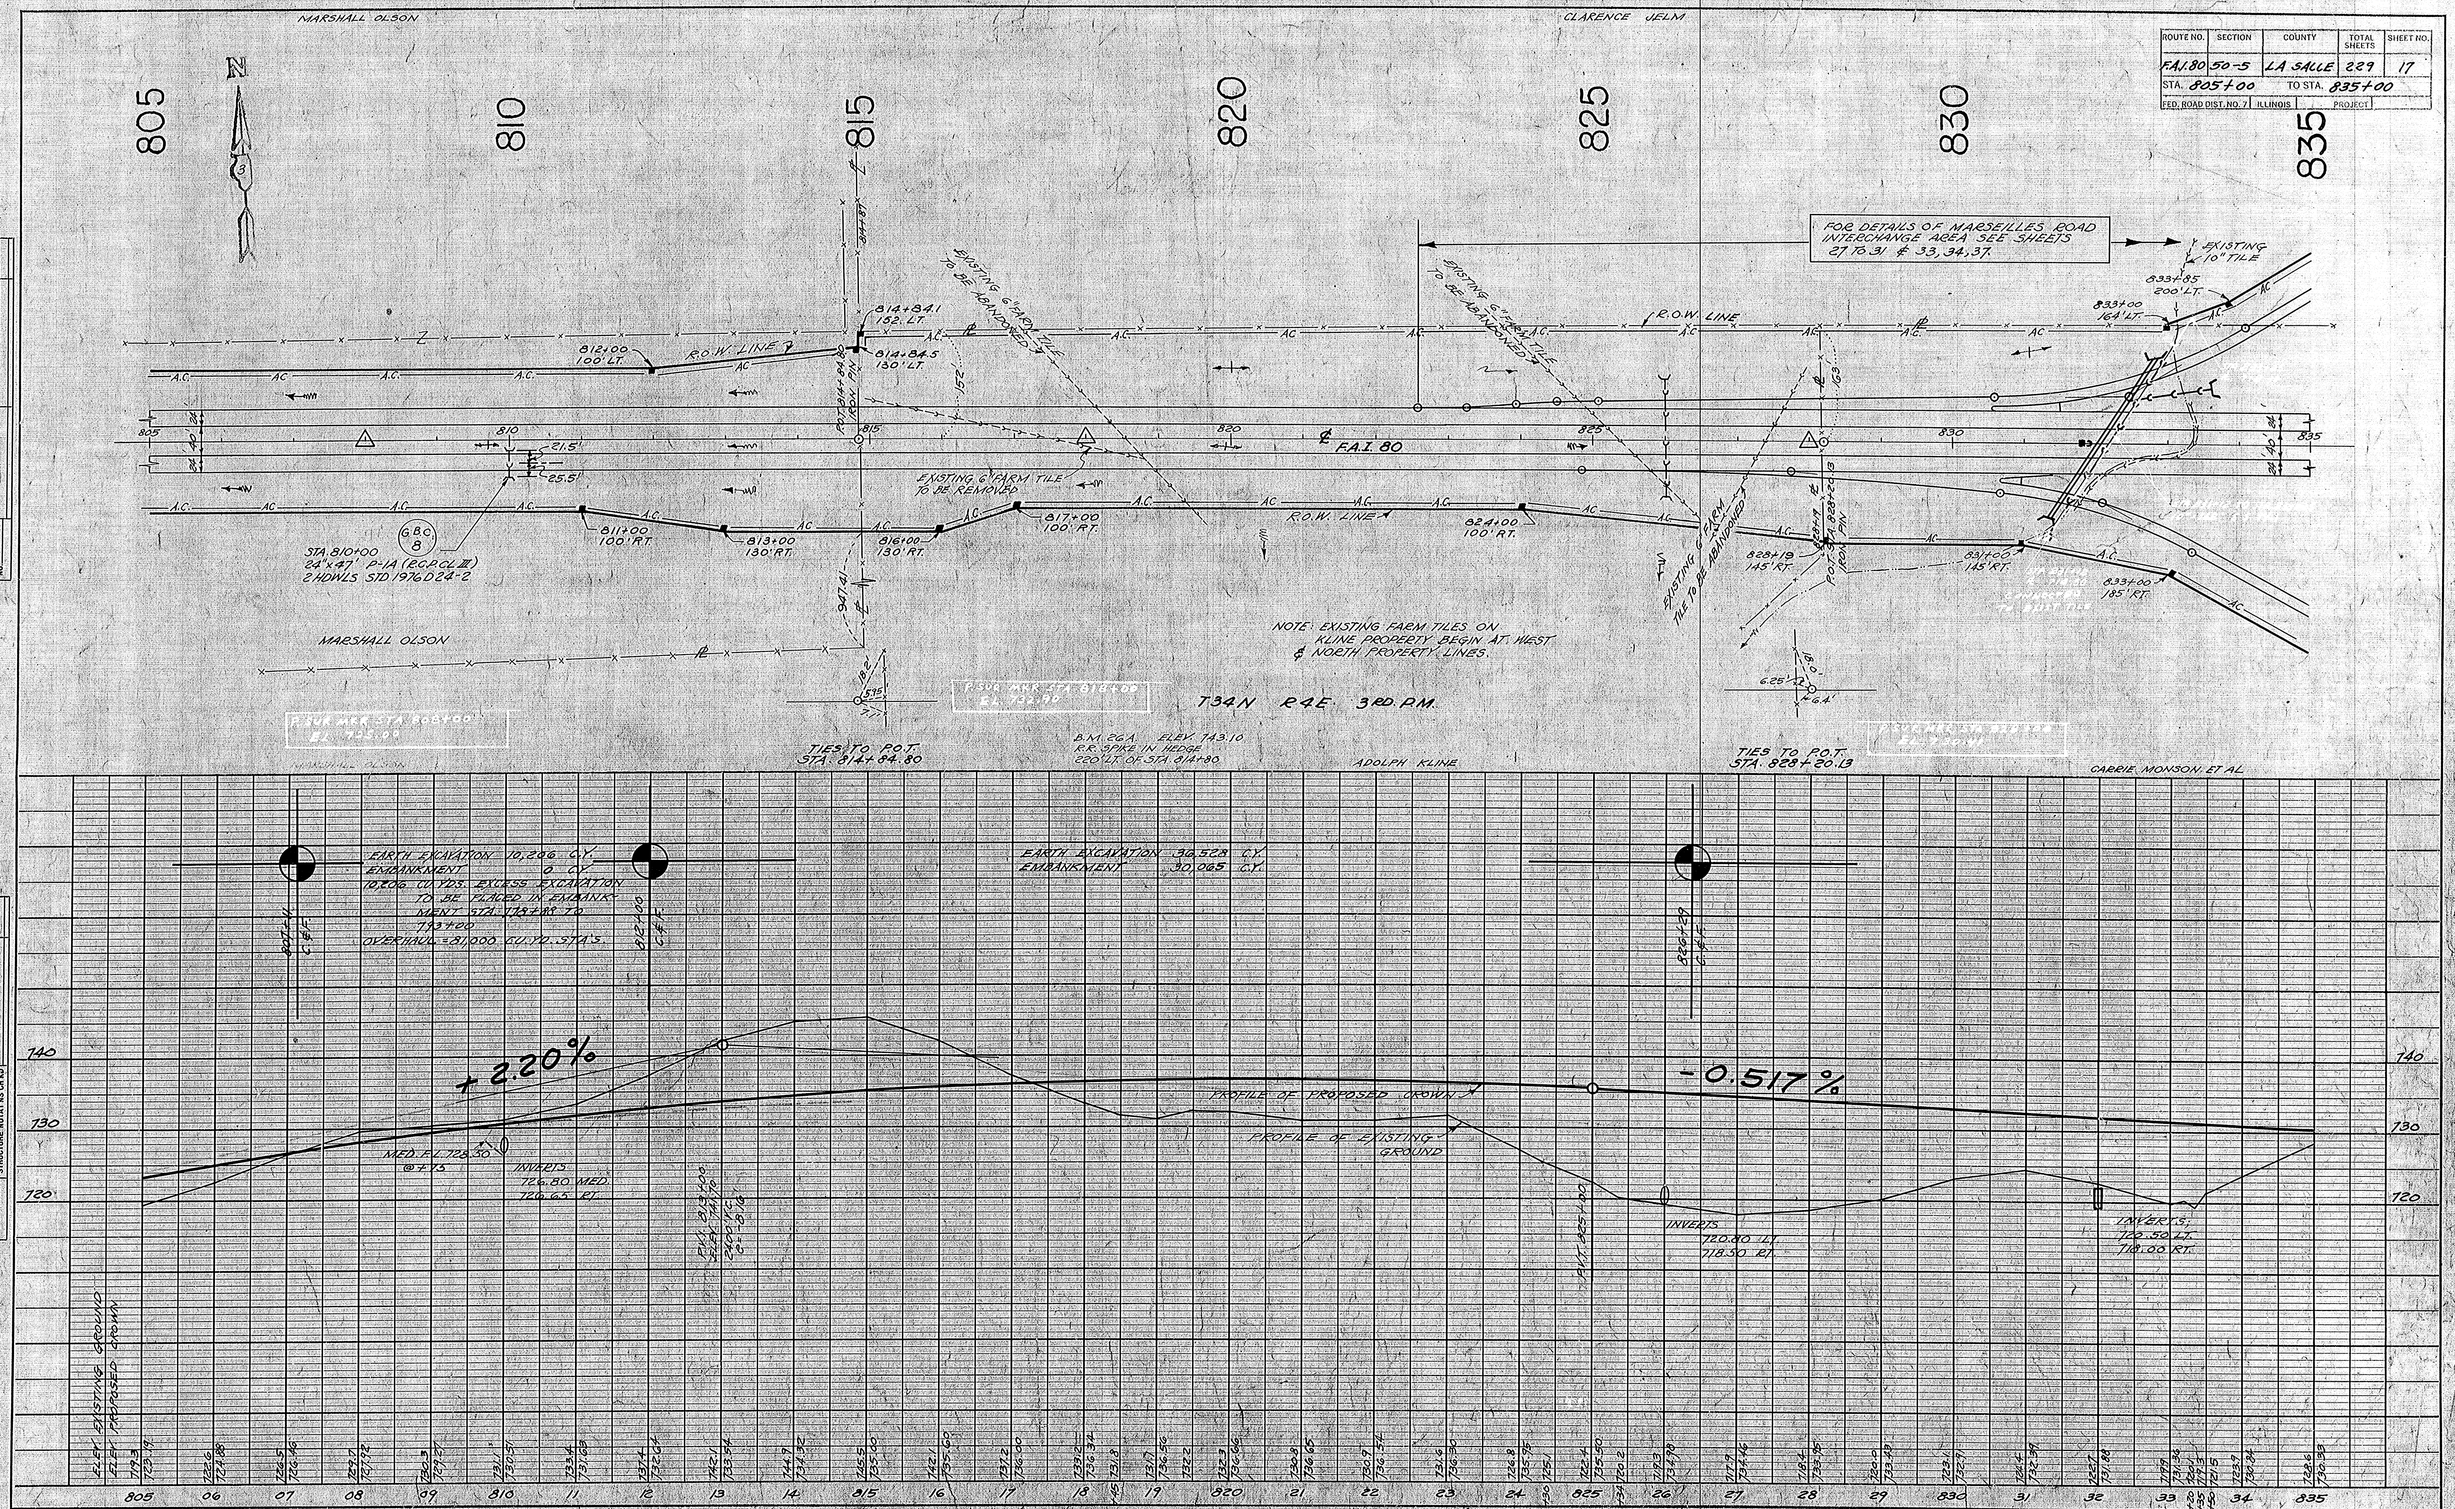

PLAN

SURVEYED
PLOTTED
ALIGNMENT CHECKED
RT. OF WAY CHECKED
NOTE BOOK
NO.
DATE
BY

PROFILE

SURVEYED
PLOTTED
GRADES CHECKED
B.M.s NOTED
STRUCTURE NOTATIONS CHKD
NOTE BOOK
NO.
DATE
BY

PLATE 1 PLAN - PROFILE B.P.R. STANDARD

Printed in U.S.A. On IMPERIAL Tracing Cloth

Printed in U.S.A. On IMPERIAL Tracing Cloth