ROUTE NO.	SECTION	COUNTY	TOTAL SHEETS	SHEET NO.
FAI 80	50-5	LA SALLE	229	104
STA. 755+00	TO STA. 761+70			
FED. ROAD DIST. NO. 7 ILLINOIS		PROJECT		

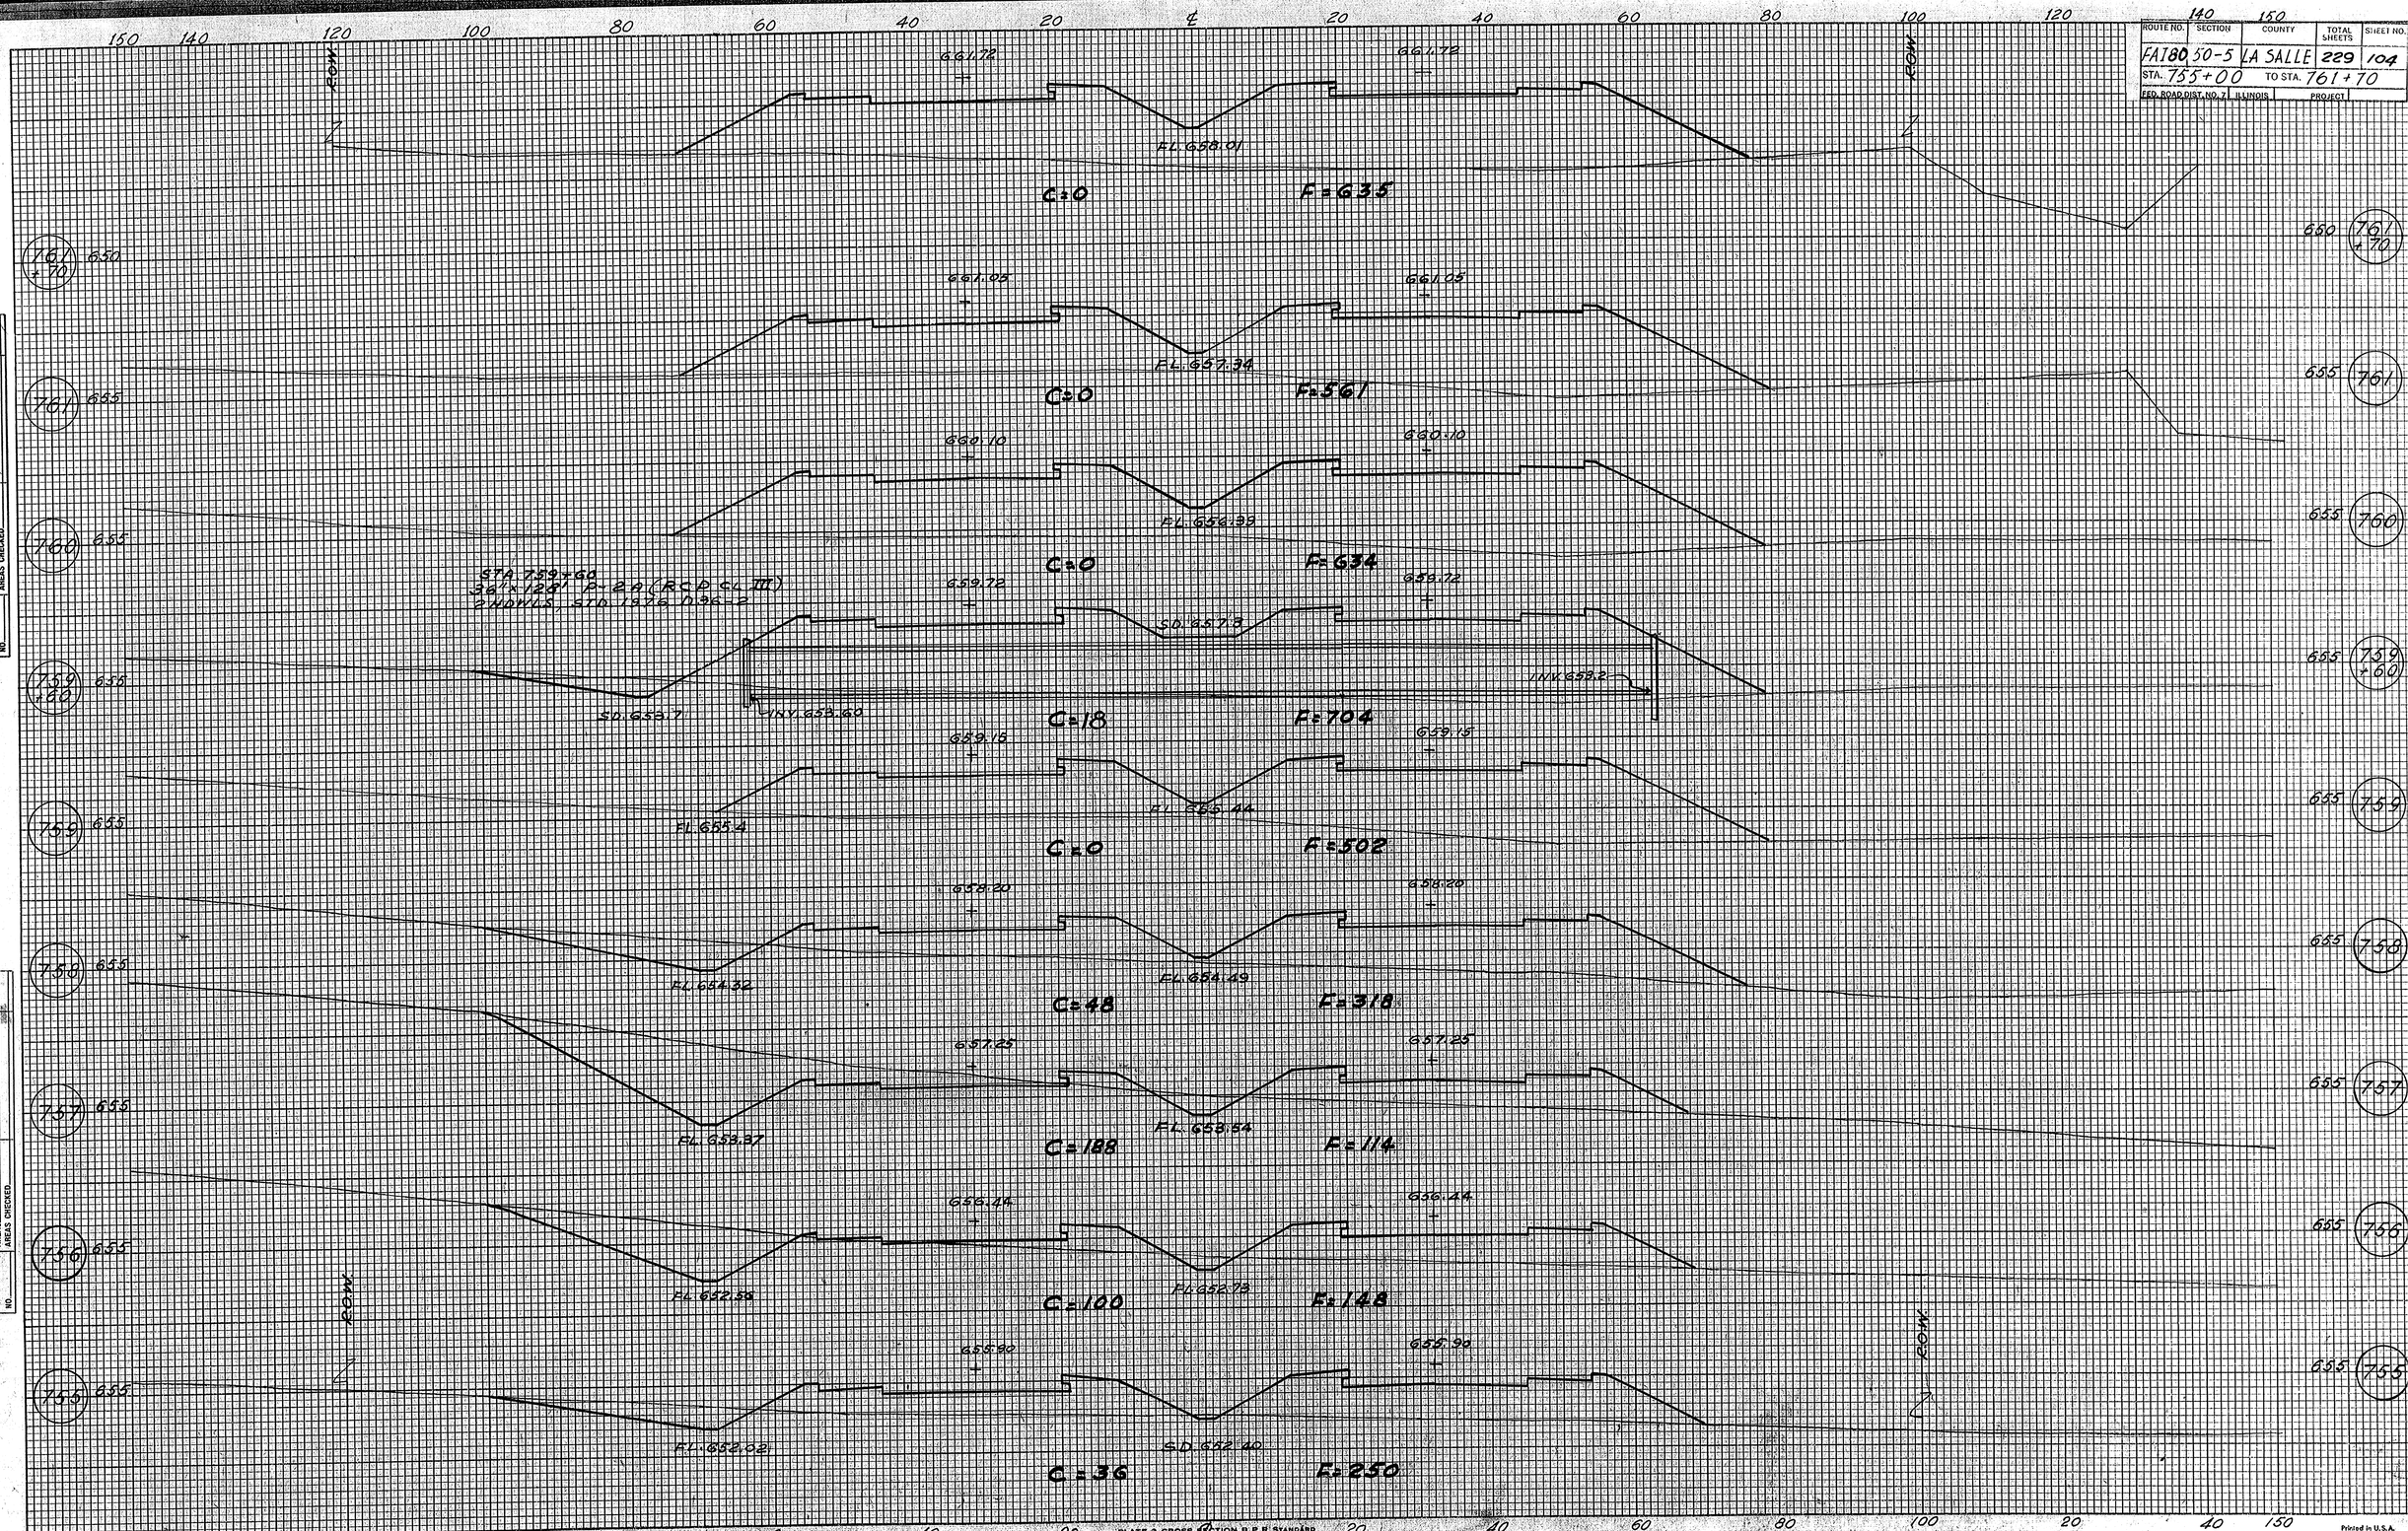

FINAL SURVEY	BY	DATE
SURVEYED		
PLOTTED		
TEMPLATE		
AREAS		
AREAS CHECKED		
NOTE BOOK		
NO.		

ORIGINAL SURVEY	BY	DATE
SURVEYED		
PLOTTED		
TEMPLATE		
AREAS		
AREAS CHECKED		
NOTE BOOK		
NO.		

PLATE 3 CROSS SECTION B.P.R. STANDARD
EUGENE DIETZGEN CO. CHICAGO-NEW YORK

Printed in U.S.A.
On IMPERIAL Tracing Cloth