ROUTE NO.	SECTION	COUNTY	TOTAL SHEETS	SHEET NO.
FAI 80	50-5	LA SALLE	229	105
STA. 761+87		TO STA. 764+15		
FED. ROAD DIST. NO. 7	ILLINOIS		PROJECT	

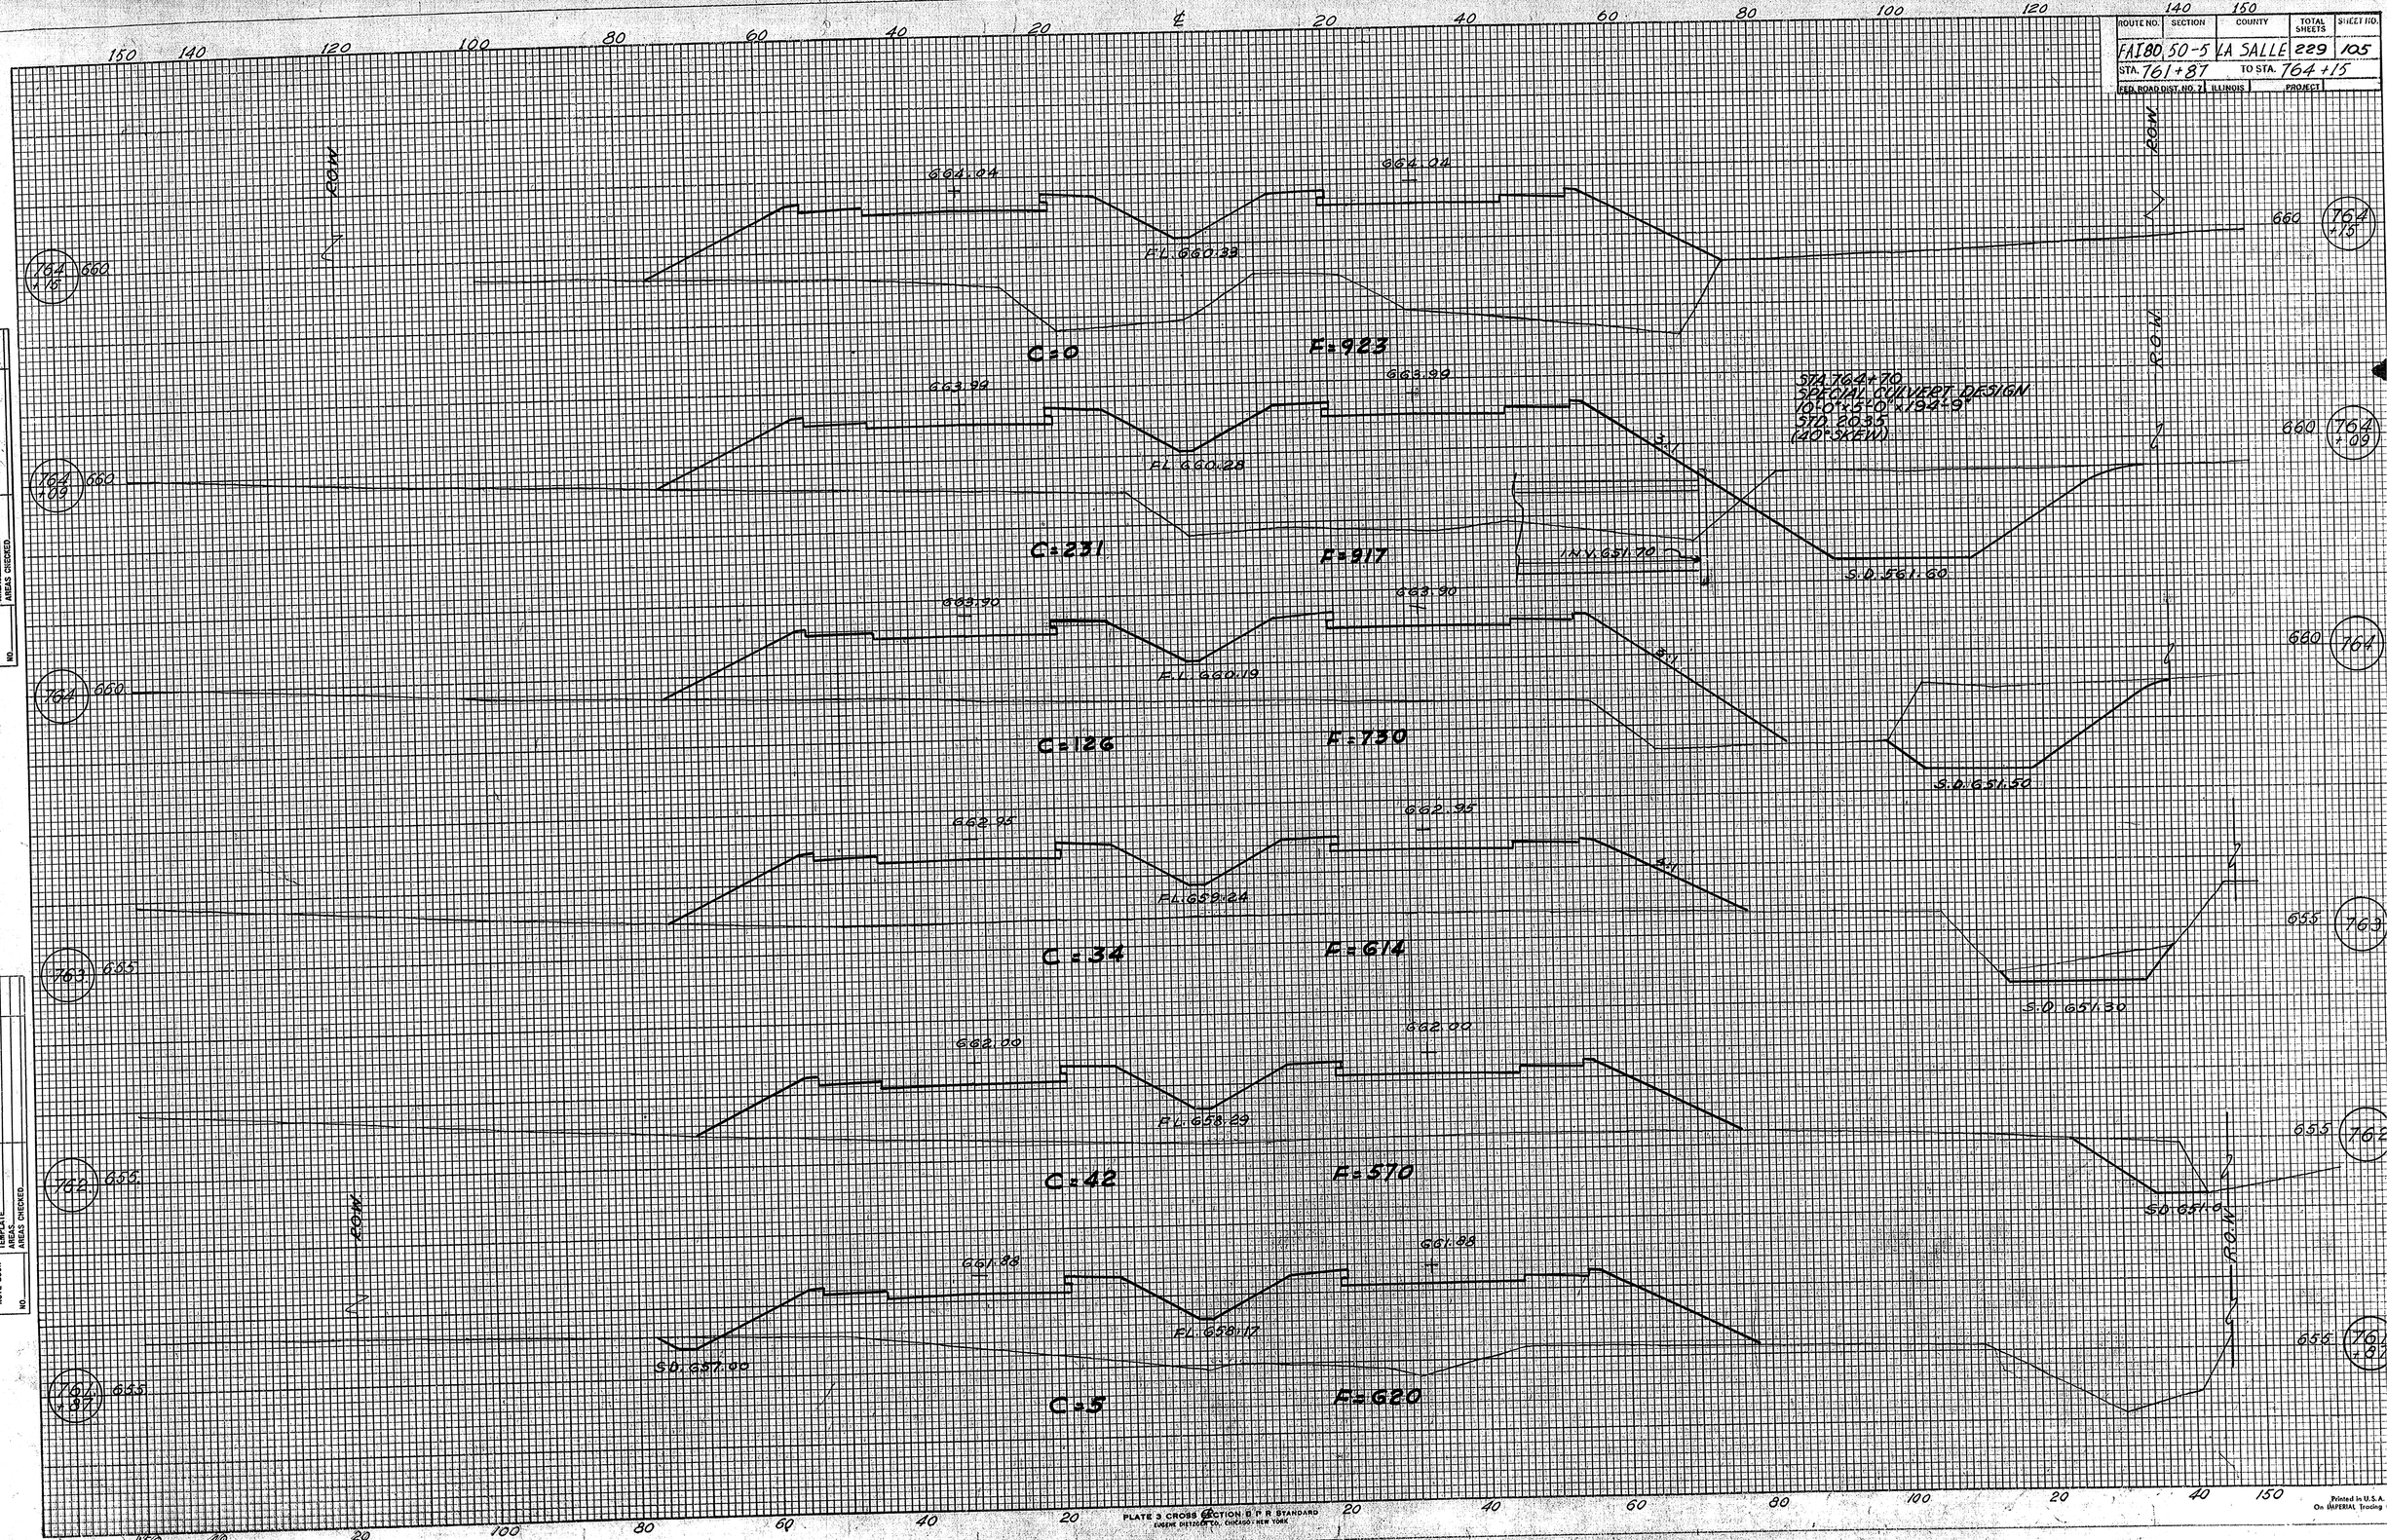

ORIGINAL SURVEY	BY	DATE
NOTE BOOK	SURVEYED.	
	PLOTTED.	
	TEMPLATE.	
	AREAS.	
NO.	AREAS CHECKED.	

FINAL SURVEY	BY	DATE
NOTE BOOK	SURVEYED.	
	PLOTTED.	
	TEMPLATE.	
	AREAS.	
NO.	AREAS CHECKED.	

PLATE 3 CROSS SECTION B.P.R. STANDARD

EUGENE DIETZGEN CO. CHICAGO · NEW YORK
Printed in U.S.A. On IMPERIAL Tracing Cloth