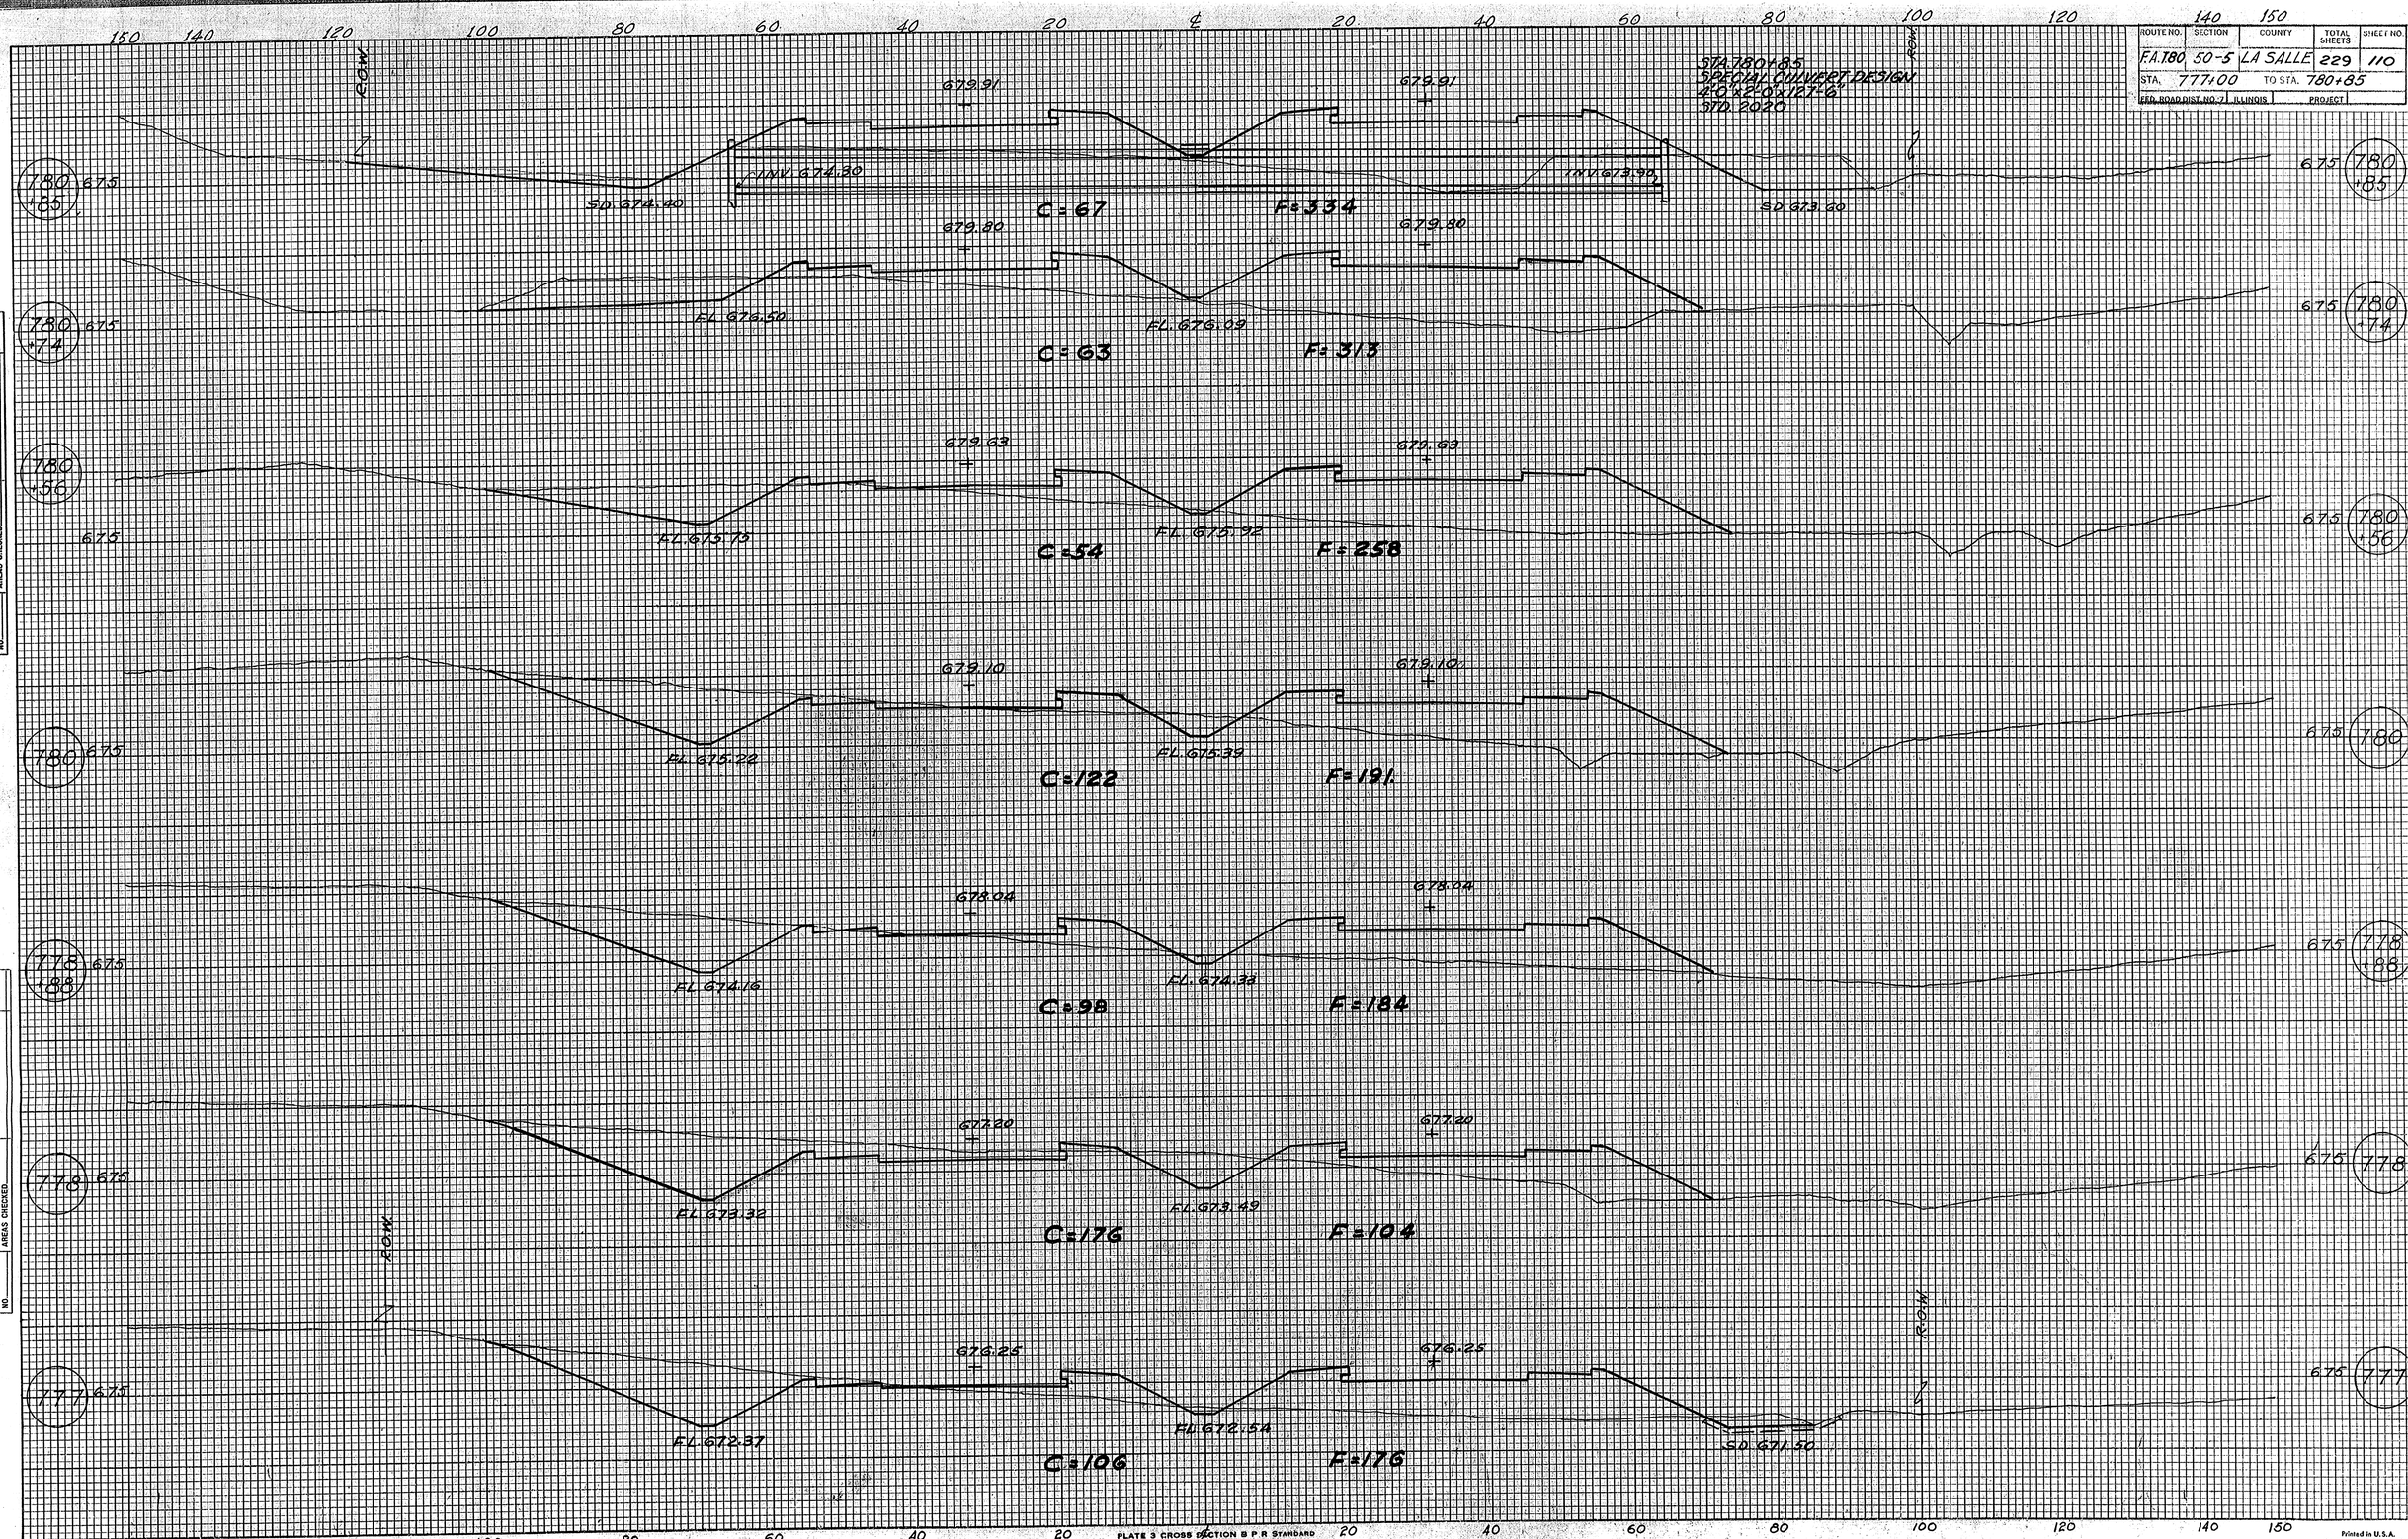

FINAL SURVEY		
NOTE BOOK	SURVEYED	
NO.	PLOTTED	
	TEMPLATE	
	AREAS	
	AREAS CHECKED	

ORIGINAL SURVEY		
NOTE BOOK	SURVEYED	
NO.	PLOTTED	
	TEMPLATE	
	AREAS	
	AREAS CHECKED	

PLATE 3 CROSS SECTION B P R STANDARD
EUGENE DIETZGEN CO. CHICAGO - NEW YORK

Printed in U.S.A. On IMPERIAL Tracing Cloth