ROUTE NO.	SECTION	COUNTY	TOTAL SHEETS	SHEET NO.
FAI.80	50-5	LA SALLE	229	111
STA. 781+00		TO STA. 786+00		
FED. ROAD DIST. NO. 7	ILLINOIS		PROJECT	

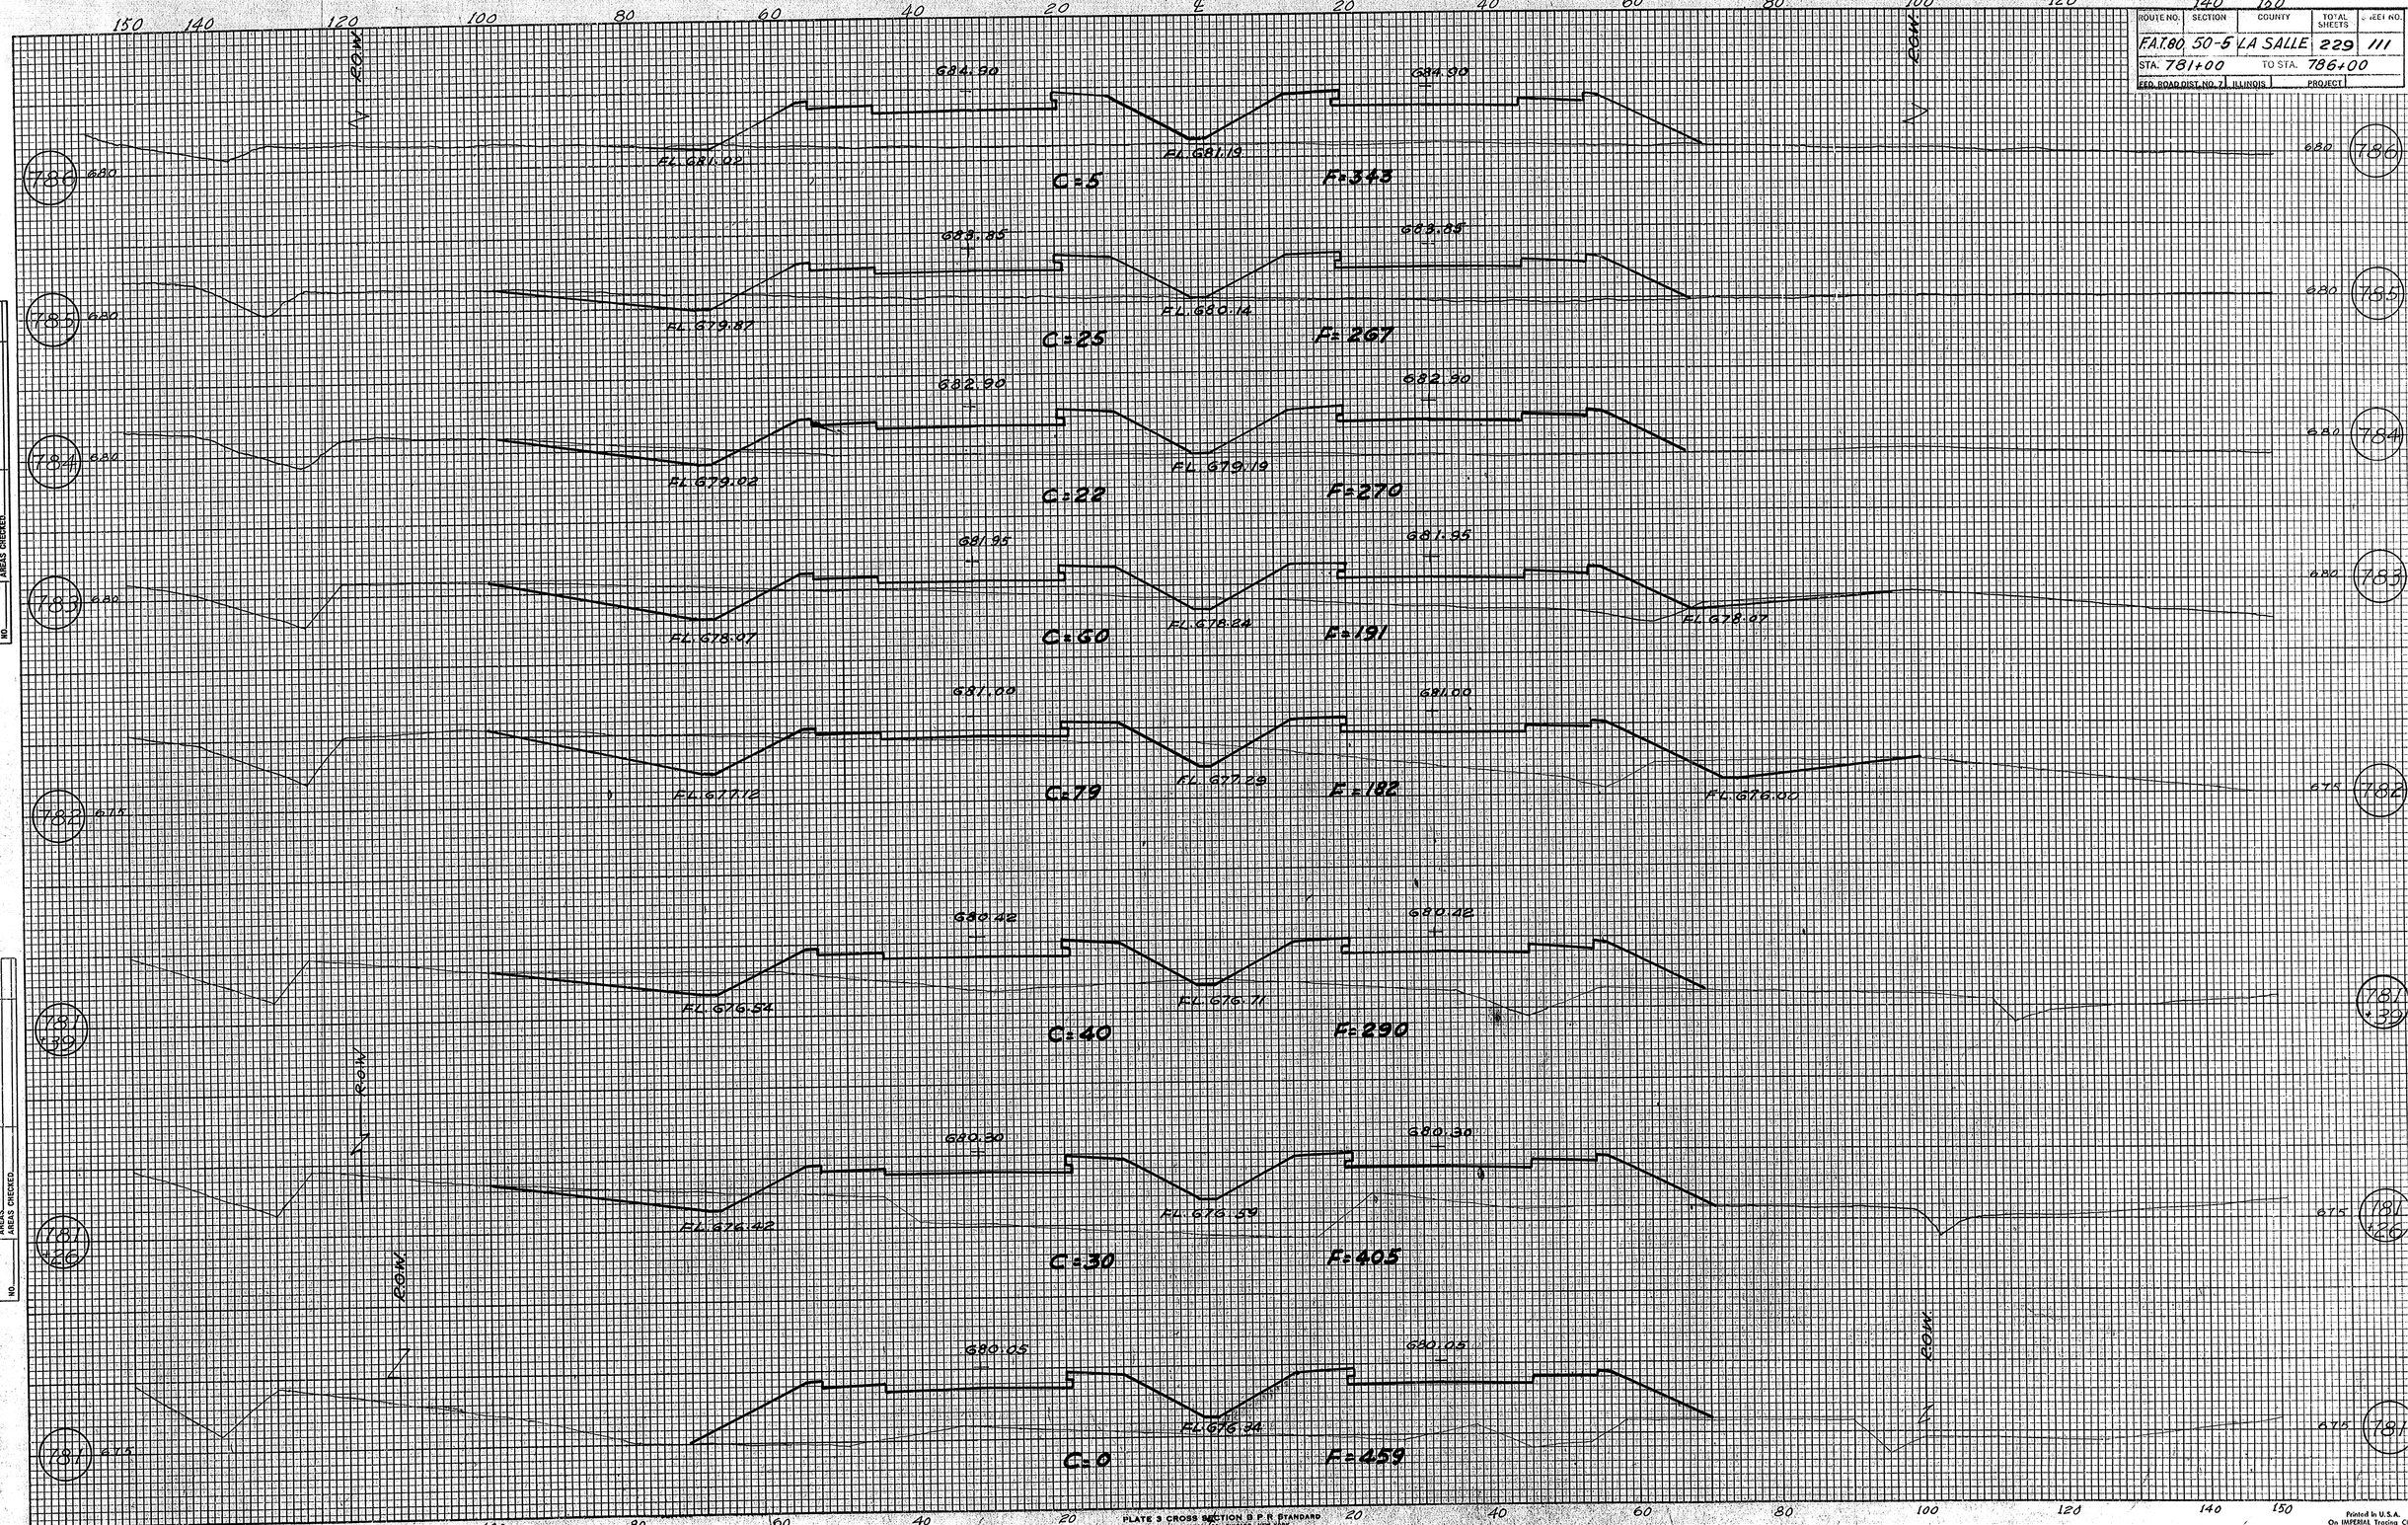

FINAL SURVEY	BY	DATE
SURVEYED		
PLOTTED		
TEMPLATE		
AREAS		
AREAS CHECKED		
NOTE BOOK		
NO.		

ORIGINAL SURVEY	BY	DATE
SURVEYED		
PLOTTED		
TEMPLATE		
AREAS		
AREAS CHECKED		
NOTE BOOK		
NO.		

PLATE 3 CROSS SECTION B.P.R. STANDARD
EUGENE DIETZGEN CO. CHICAGO NEW YORK

Printed in U.S.A.
On IMPERIAL Tracing Cloth