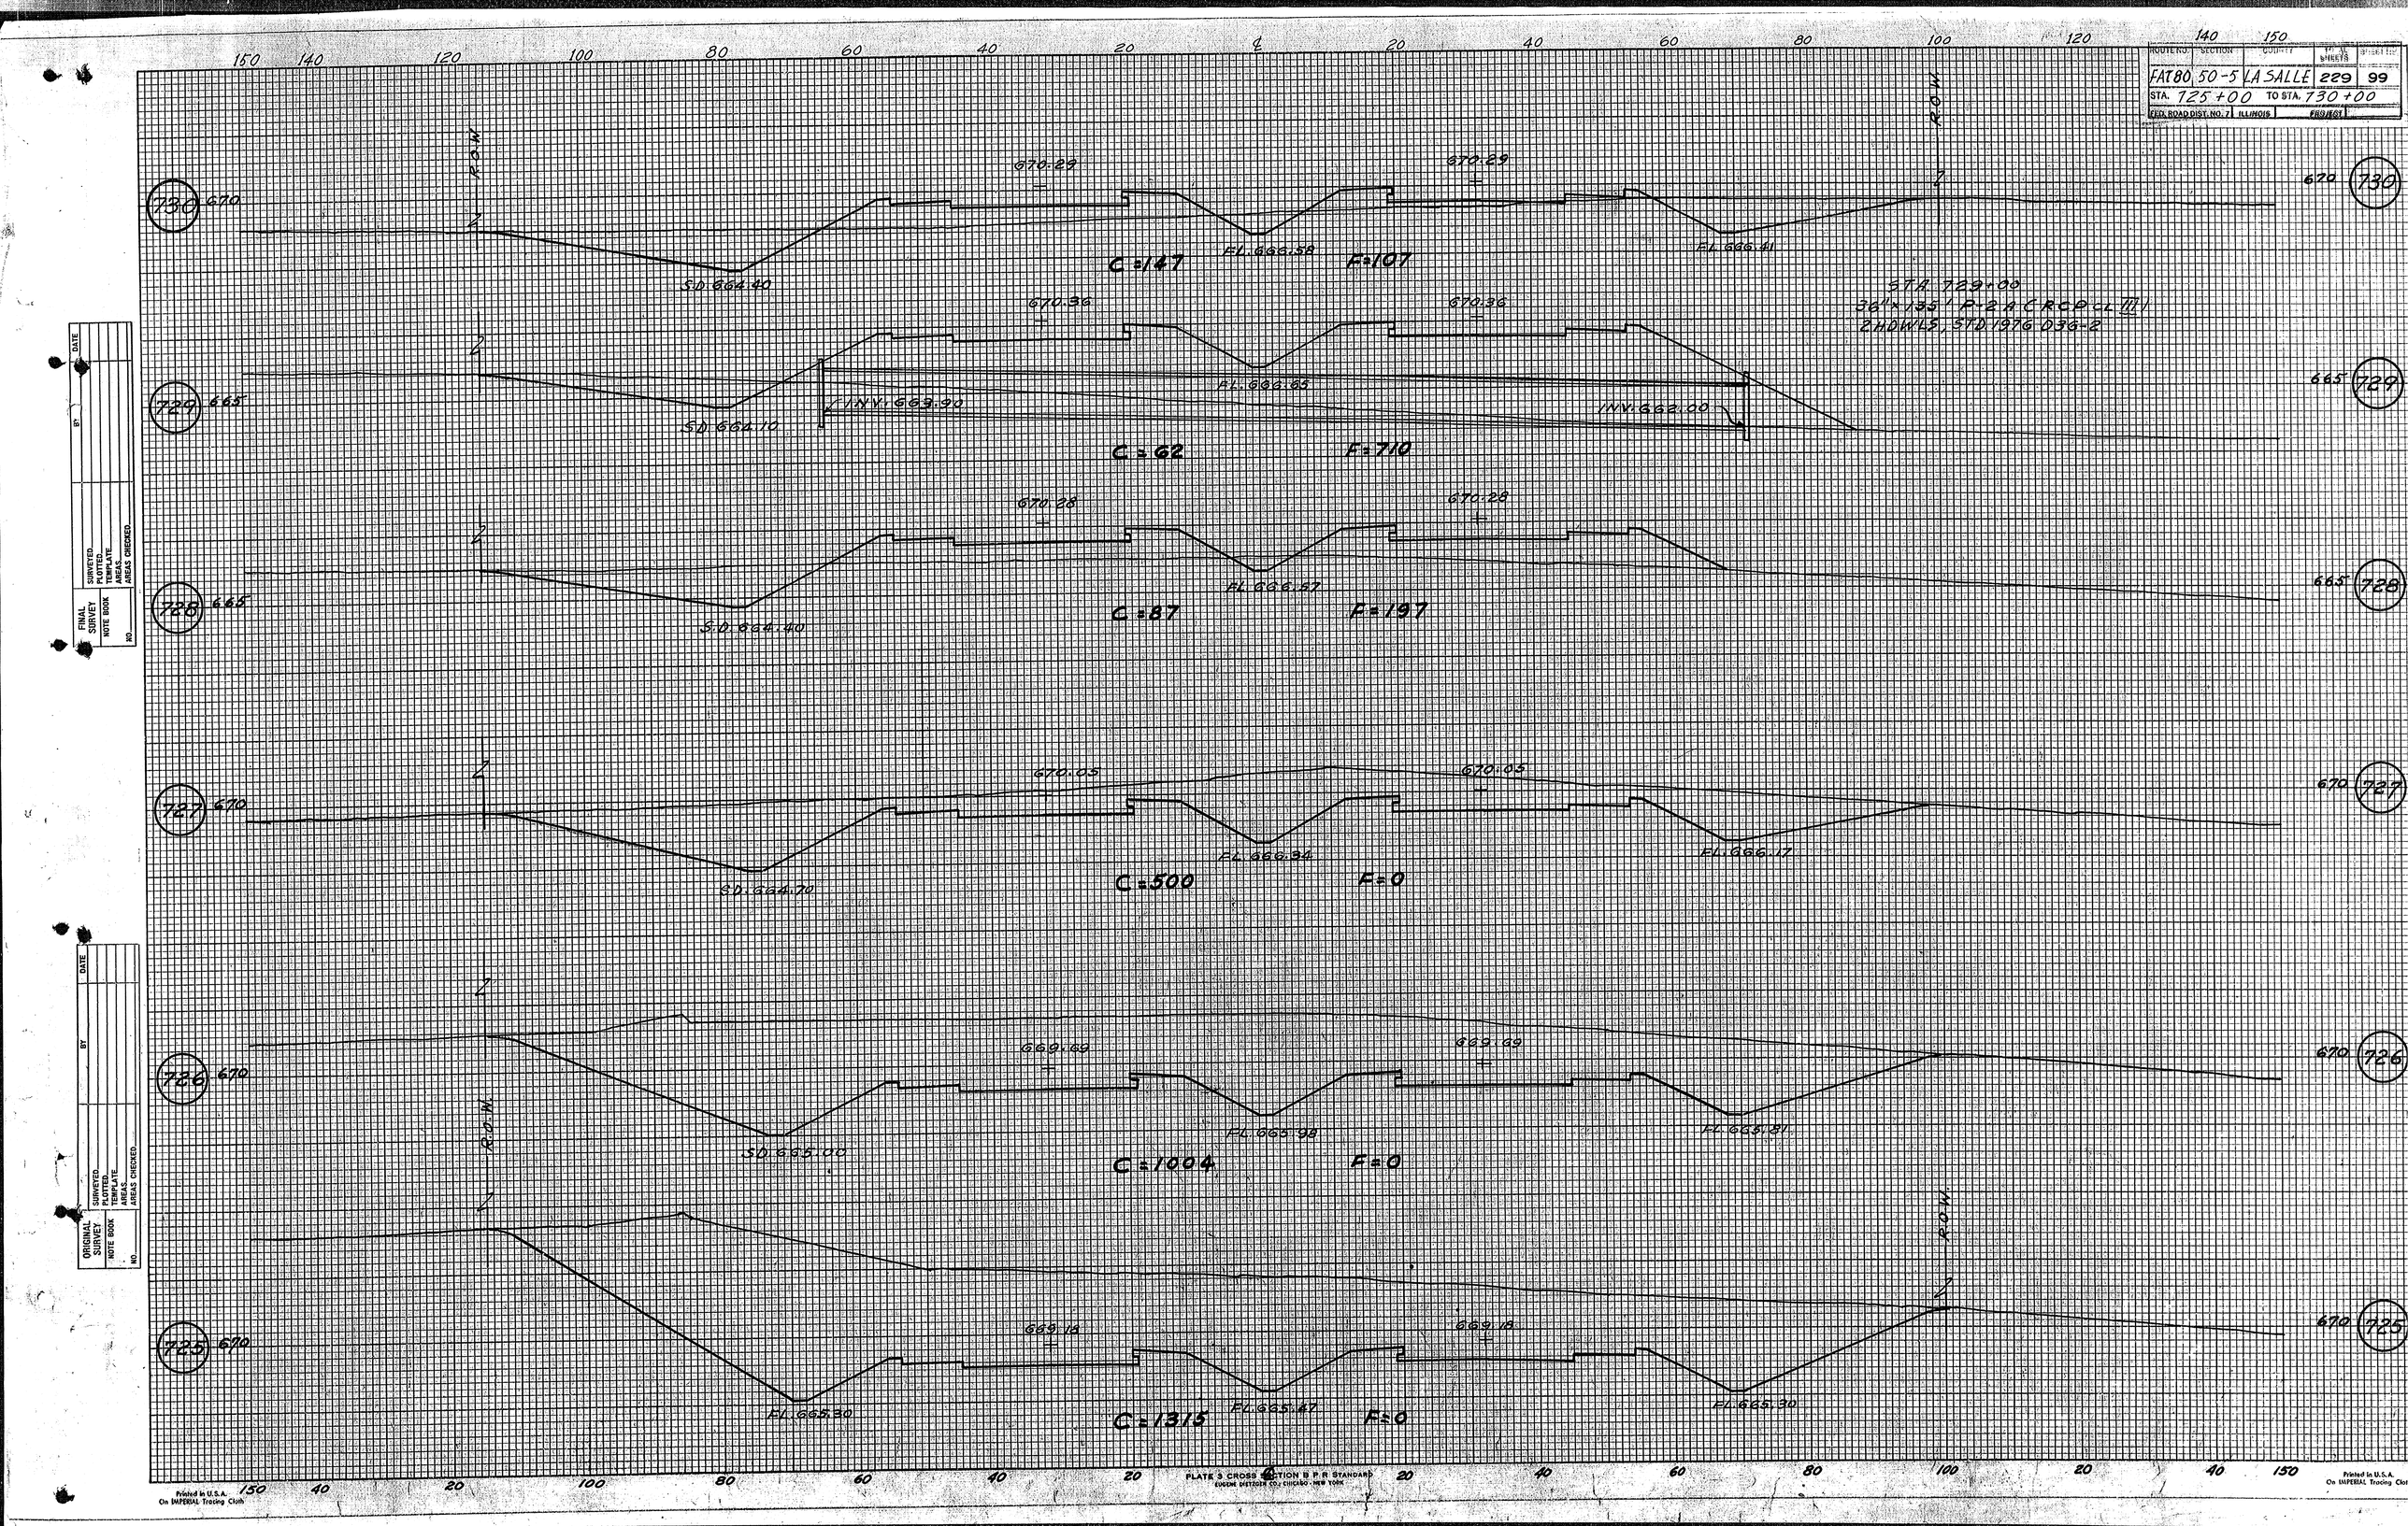

ROUTE NO. FAT 80
SECTION 50-5
COUNTY LA SALLE
TOTAL SHEETS 229
SHEET NO. 99
STA. 725+00 TO STA. 730+00
FED. ROAD DIST. NO. 7
ILLINOIS
PROJECT
R.O.W.
730 670
670.29
670.29
S.D. 664.40
FL. 666.58
FL. 666.41
C=147
F=107
STA. 729+00
36" x 135' P-2 A CRCP CL III
2 HDWLS, STD. 1976 D36-2
729 665
670.36
670.36
S.D. 664.10
INV. 663.90
FL. 666.65
INV. 662.00
C=62
F=710
728 665
670.28
670.28
S.D. 664.40
FL. 666.57
C=87
F=197
727 670
670.05
670.05
S.D. 664.70
FL. 666.34
FL. 666.17
C=500
F=0
726 670
669.69
669.69
S.D. 665.00
FL. 665.98
FL. 665.81
C=1004
F=0
725 670
669.18
669.18
FL. 665.30
FL. 665.47
FL. 665.30
C=1315
F=0
FINAL SURVEY
NOTE BOOK
NO.
SURVEYED
PLOTTED
TEMPLATE
AREAS
AREAS CHECKED
BY
DATE
ORIGINAL SURVEY
NOTE BOOK
NO.
SURVEYED
PLOTTED
TEMPLATE
AREAS
AREAS CHECKED
BY
DATE
PLATE 3 CROSS SECTION B.P.R. STANDARD
EUGENE DIETZGEN CO. CHICAGO - NEW YORK
Printed in U.S.A.
On IMPERIAL Tracing Cloth