ROUTE NO.	SECTION	COUNTY	TOTAL SHEETS	SHEET N
FAT 80	50-5	LA SALLE	229	100

STA. 731+00 TO STA. 736+00

FED. ROAD DIST. NO. 7 ILLINOIS | PROJECT

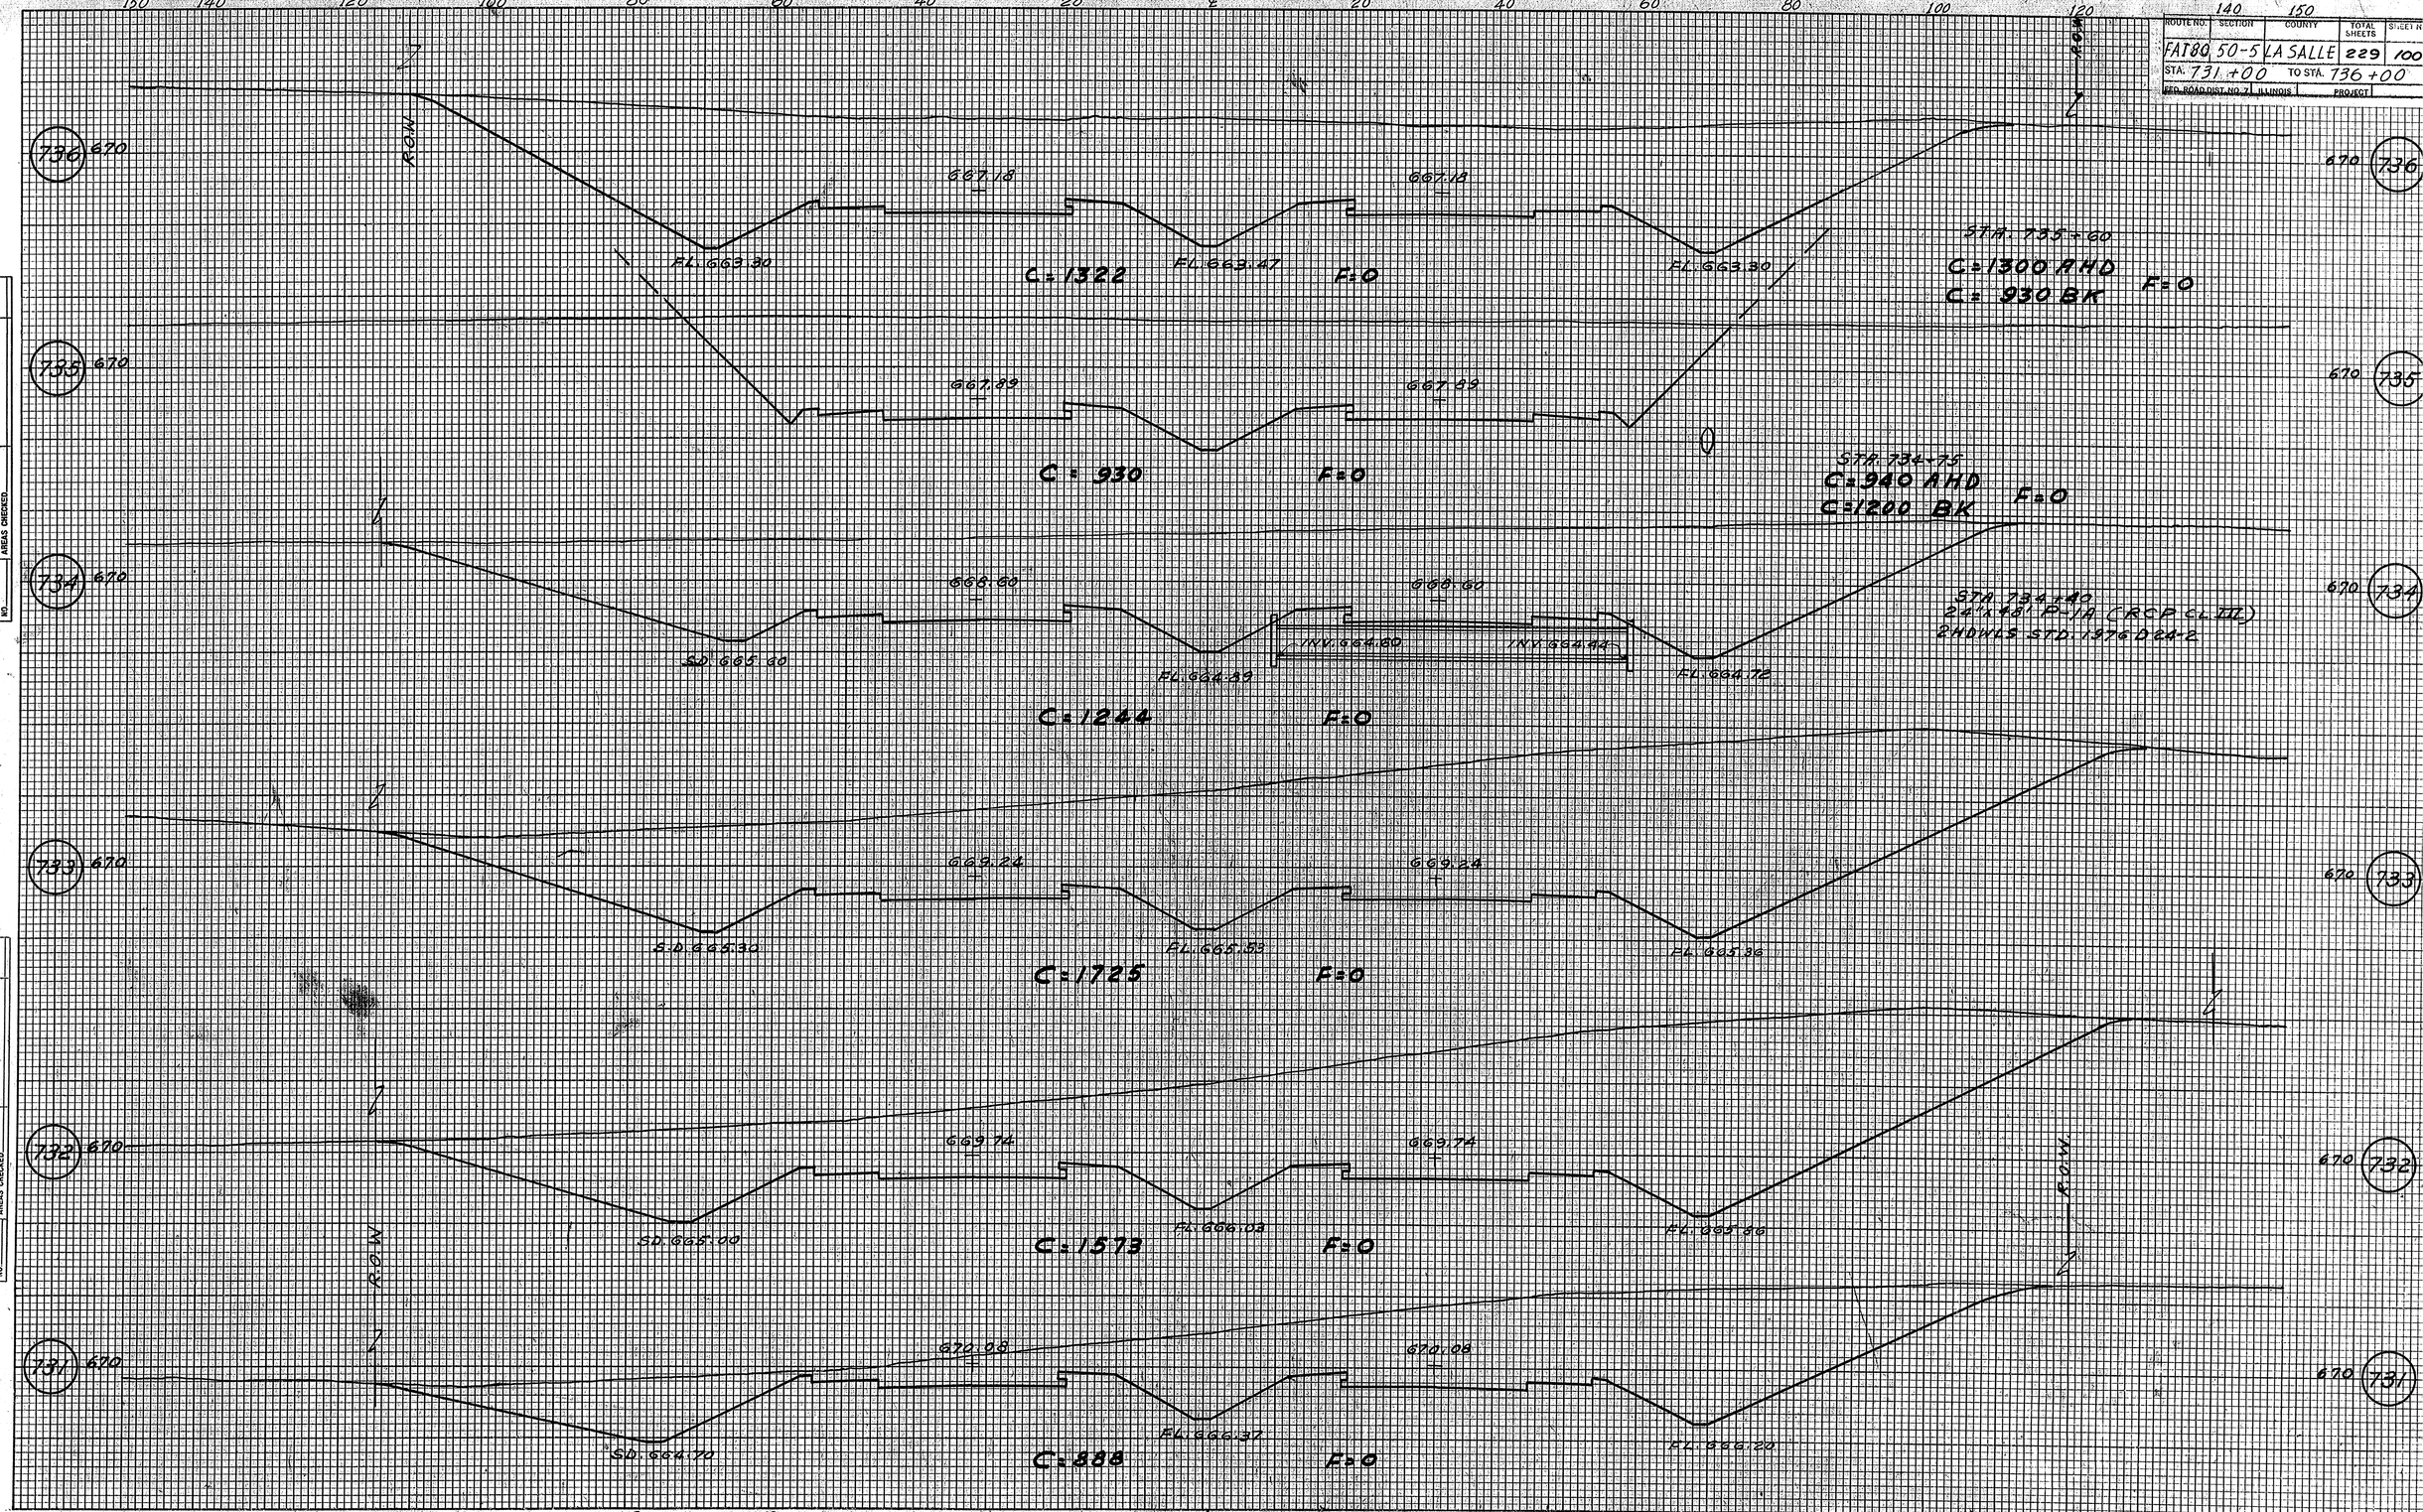

FINAL SURVEY	BY	DATE
SURVEYED		
PLOTTED		
TEMPLATE		
AREAS		
AREAS CHECKED		
NOTE BOOK		
NO.		

ORIGINAL SURVEY	BY	DATE
SURVEYED		
PLOTTED		
TEMPLATE		
AREAS		
AREAS CHECKED		
NOTE BOOK		
NO.		

Printed in U.S.A.
On IMPERIAL Tracing Cloth

PLATE 3 CROSS SECTION B P R STANDARD
EUGENE DIETZGEN CO. CHICAGO · NEW YORK

Printed in U.S.A.
On IMPERIAL Tracing Cloth